

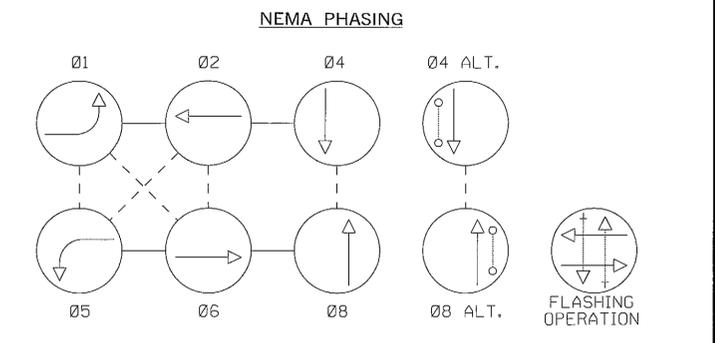
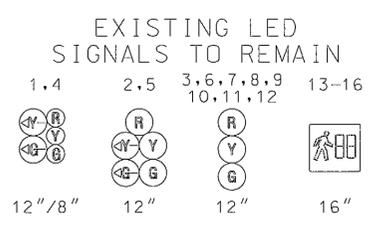
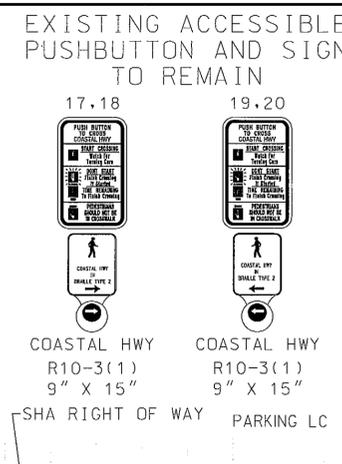


MD 586 IS ASSUMED TO RUN IN A NORTH-SOUTH DIRECTION

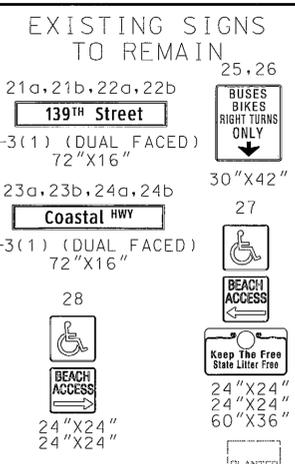

NOTE:
PHASES ASSOCIATED BY A DASHED LINE WILL OPERATE CONCURRENTLY.
PHASES ASSOCIATED BY A SOLID LINE WILL NOT OPERATE CONCURRENTLY.

SPECIAL NOTE
REFER TO ROADWAY PLANS FOR SIDEWALK DETAILS.

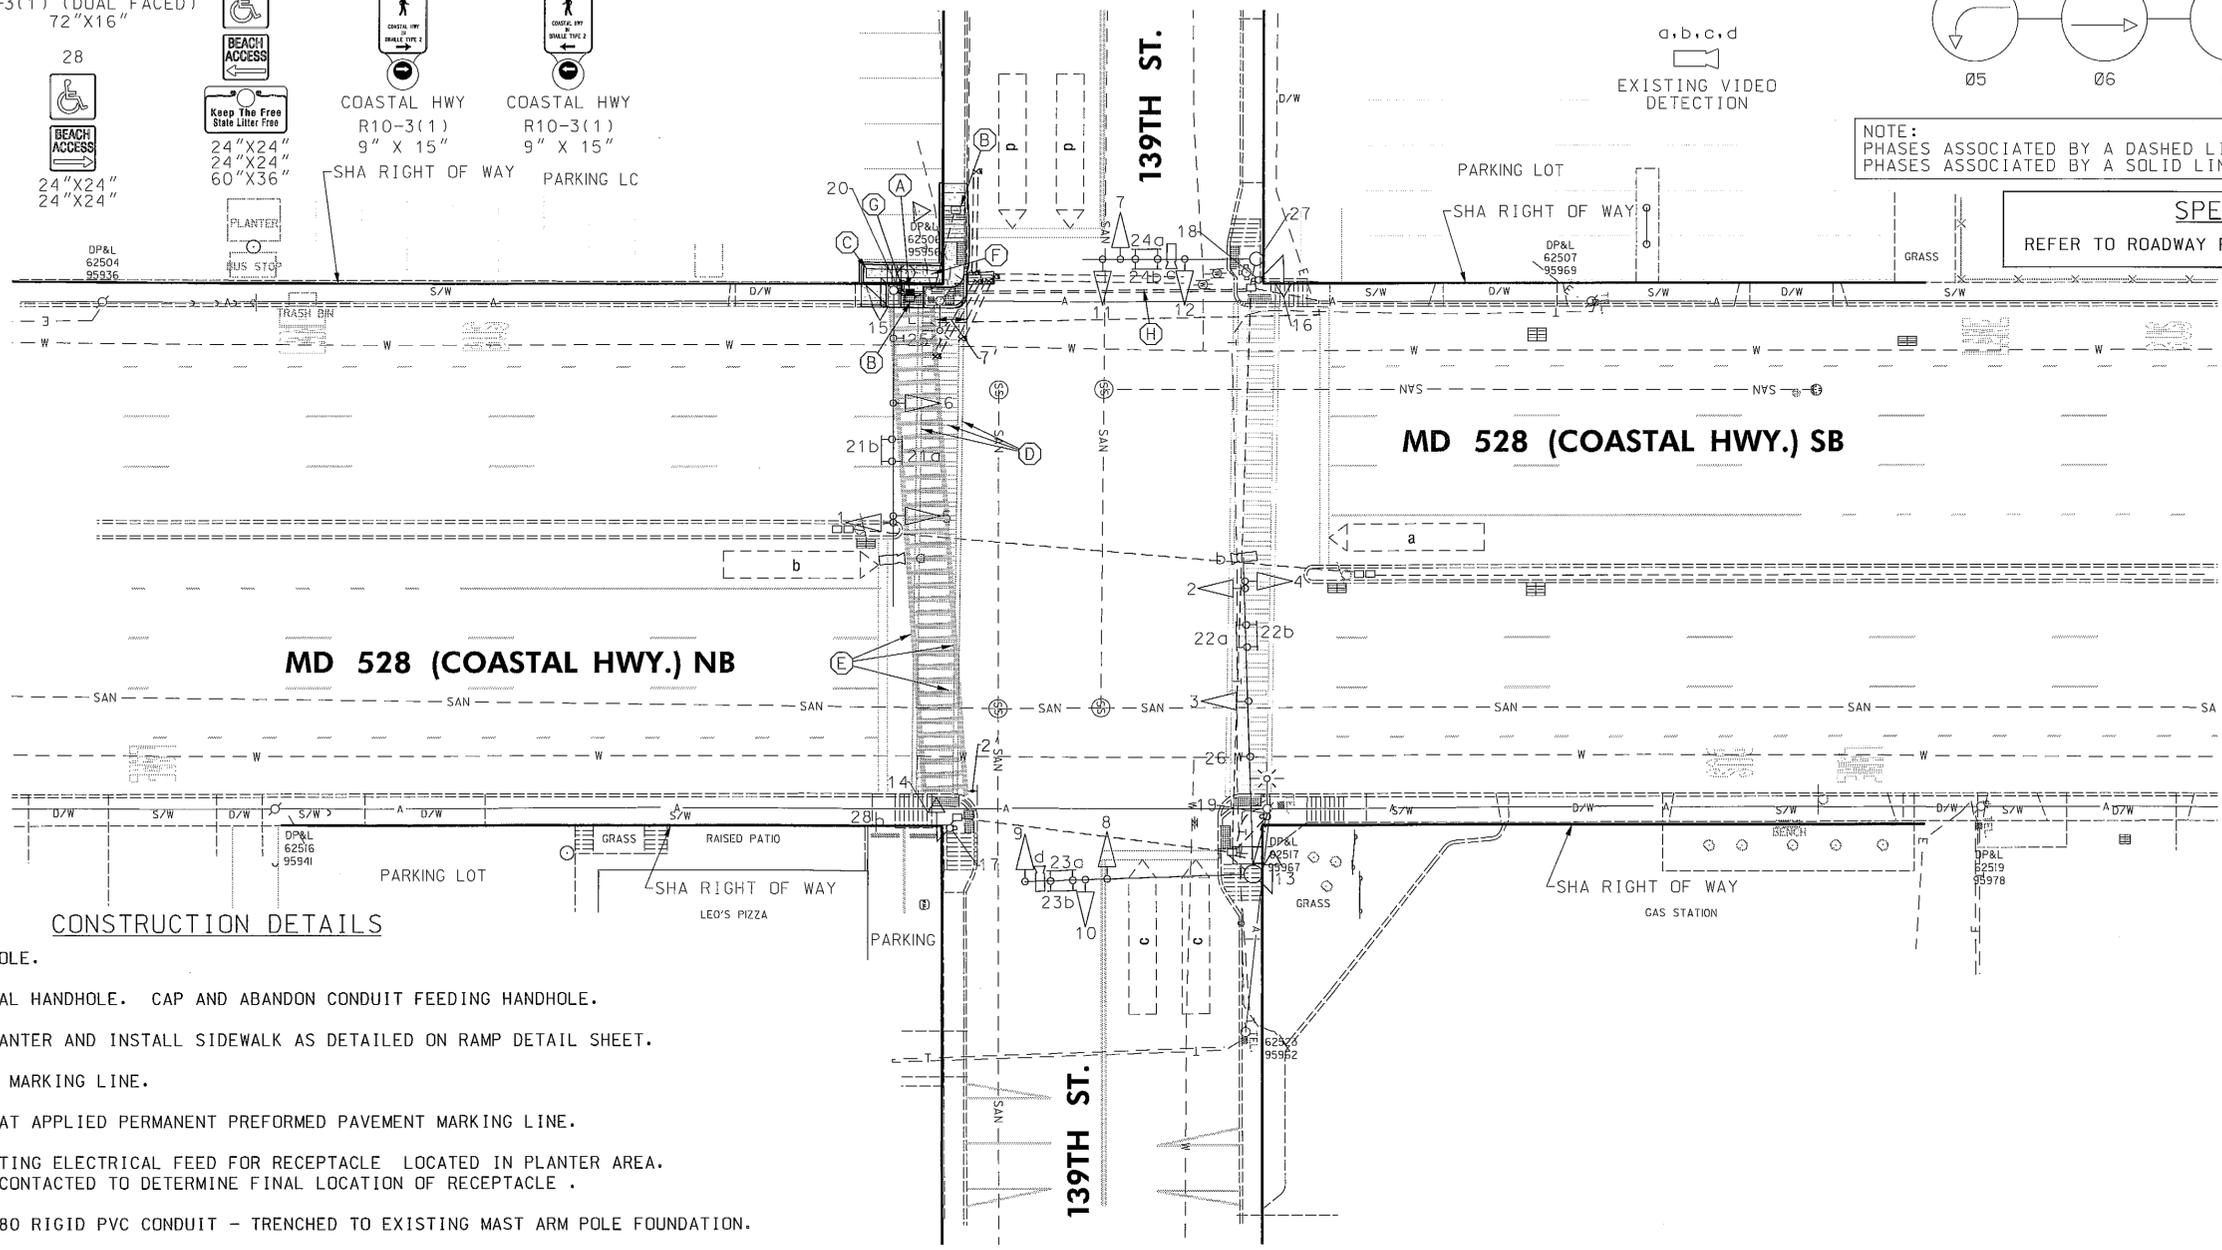

- CONSTRUCTION DETAILS**
- A. INSTALL ELECTRICAL HANDHOLE.
 - B. REMOVE EXISTING ELECTRICAL HANDHOLE. CAP AND ABANDON CONDUIT FEEDING HANDHOLE.
 - C. REMOVE EXISTING STONE PLANTER AND INSTALL SIDEWALK AS DETAILED ON RAMP DETAIL SHEET.
 - D. REMOVE EXISTING PAVEMENT MARKING LINE.
 - E. INSTALL 12 INCH WHITE HEAT APPLIED PERMANENT PREFORMED PAVEMENT MARKING LINE.
 - F. REMOVE AND RELOCATE EXISTING ELECTRICAL FEED FOR RECEPTACLE LOCATED IN PLANTER AREA. PROPERTY OWNER SHALL BE CONTACTED TO DETERMINE FINAL LOCATION OF RECEPTACLE.
 - G. INSTALL 3 INCH SCHEDULE 80 RIGID PVC CONDUIT - TRENCHED TO EXISTING MAST ARM POLE FOUNDATION.
 - H. INSTALL 4 INCH SCHEDULE 80 RIGID PVC CONDUIT - BORED.

GEOMETRIC LEGEND

--- EXISTING
--- PROPOSED

UTILITY LEGEND

SD	SD	STORM DRAIN
G	G	GAS MAIN
W	W	WATER MAIN
SAN	SAN	SEWER MAIN
E	E	ELECTRIC CABLES
A	A	AERIAL CABLES
T	T	TELEPHONE CABLES
F	F	FIBER-OPTIC

RK&K
Rummel, Klepper & Kahl, LLP
81 MOSHER STREET | BALTIMORE, MD 21217
PH: (410) 728-2500 FAX: (410) 728-3160
www.rkk.com

APPROVALS

TEAM LEADER
ASST. DIV. CHIEF
DIVISION CHIEF
OFFICE DIRECTOR

REVISIONS

C	RECONSTRUCT SW CORNER TO MEET ADA REQUIREMENTS XX4435185	05-10
B	RECONSTRUCT SIGNAL TO MEET ADA REQUIREMENTS XX4435185 - K186	04-10
B/JG	KP DBD ROB CS TH	
A	INSTALL RESTRICTED RIGHT LANE SIGNS AT9095185	05-01-08
MR		TH

SHA STATE OF MARYLAND
DEPARTMENT OF TRANSPORTATION
STATE HIGHWAY ADMINISTRATION
OFFICE OF TRAFFIC & SAFETY
TRAFFIC ENGINEERING DESIGN DIVISION

MD 528 (COASTAL HWY.) AT 139TH ST.
OCEAN CITY, MARYLAND

TRAFFIC SIGNAL PLAN

SCALE 1"=20' DATE 01-30-07 CONTRACT NO. W0-653-451-185

DESIGNED BY R. ZACHERL COUNTY WORCESTER
DRAWN BY S. THACKER LOGMILE 23052800.49
CHECKED BY TIMS NO. K186 Redline to 139th
FAP NO. TOD NO.

TS NO. 2316C DRAWING SG-1 OF 2 SHEET NO. 1 OF 3